

THE BOROUGH COUNCIL OF BOLTON

WILDLIFE AND COUNTRYSIDE ACT 1981

DEFINITIVE MAP AND STATEMENT FOR THE BOROUGH COUNCIL OF BOLTON

**THE BOLTON (PUBLIC FOOTPATH NO. 516 BOLTON) DEFINITIVE MAP
MODIFICATION ORDER (2) 2014**

This Order is made by the Borough Council of Bolton ("the Authority") under Section 53(2)(b) of the Wild life and Countryside Act 1981 ("the Act") because it appears to the Authority that the Definitive Map and Statement for the Borough Council of Bolton requires modification in consequence of the occurrence of an event specified in Section 53(3)(b), namely the expiration, in relation to the way specified in the Schedule below which is in the area to which the Map relates, of a period such that the enjoyment of the public of the way during that period raises a presumption that the way has been dedicated as a public path.

The Borough Council of Bolton hereby orders that:

1. For the purpose of this Order the relevant date shall be the date the Order is made.
2. The Definitive Map for the Borough Council of Bolton (relevant date 25th April 1984) and its associated Statement shall be modified as described in Part I and Part II of the Schedule and shown on the map attached to this Order.
3. This Order shall take effect on the date it is confirmed and may be cited as The Bolton (Public Footpath No. 516 Bolton) Definitive Map Modification Order (2) 2014.

THE COMMON SEAL of
THE BOROUGH COUNCIL
Of BOLTON was hereunto
affixed on the 12th day of
November 2014 in the presence

of



Authorised Sealing Officer



SEALING NO.

17292

(LS/CM 11/14)

The foregoing order is hereby confirmed
subject to the red ink modifications thereon

Sue Arnott 28 SEP 2015

An Inspector appointed by The Secretary
of State for Environment, Food and
Rural Affairs

065952/990971

SCHEDULE

PART 1

MODIFICATION OF THE DEFINITIVE MAP

Description of path to be added

A public footpath commencing from a point on the access road to Edditch Farm (an unadopted highway), off Hengist Street, Bolton, at (Point A on the Order Plan) at Grid Reference SD 373391 409123 and running for a distance of 48 metres in a generally north to south direction to join an existing path within Leverhulme Park at (Point D on the Order Plan) at Grid Reference SD 373397 409079 over a hard surface from Point A to Point C, at Grid Reference SD 373395 4090098 and a foot trodden surface from Point C to Point D. At a width of 3.96 metres at (Point A on the Order Plan) at Grid Reference SD 373391 409123 decreasing to 2.7 metres at (Point B on the Order Plan) at Grid Reference SD 373394 409106 continuing from (Point B to C to D on the Order Plan) with a width of 2.7 metres ending with (Point D on the Order) Plan at Grid Reference SD 373398 409079 and shown as a continuous line with short bars at intervals on the Order Plan.

PART II

MODIFICATION OF DEFINITIVE STATEMENT


The Definitive Statement is amended by the addition of the following entries:

Footpath No. 516 Bolton

The path has a varying width over its length from 3.96 metres to 2.7 metres

Limitations: ^{A gate} ~~An existing gate is present~~ across the whole width at Point A (on the Order Plan) and ^{a gate} ~~an existing gate is present which limits the width to 0.9 metres~~ at (Point C on the Order Plan) at Grid Reference SD 373395 409098.


Added by The Bolton (Public Footpath No. 516 Bolton) Definitive Map Modification Order (2) 2014

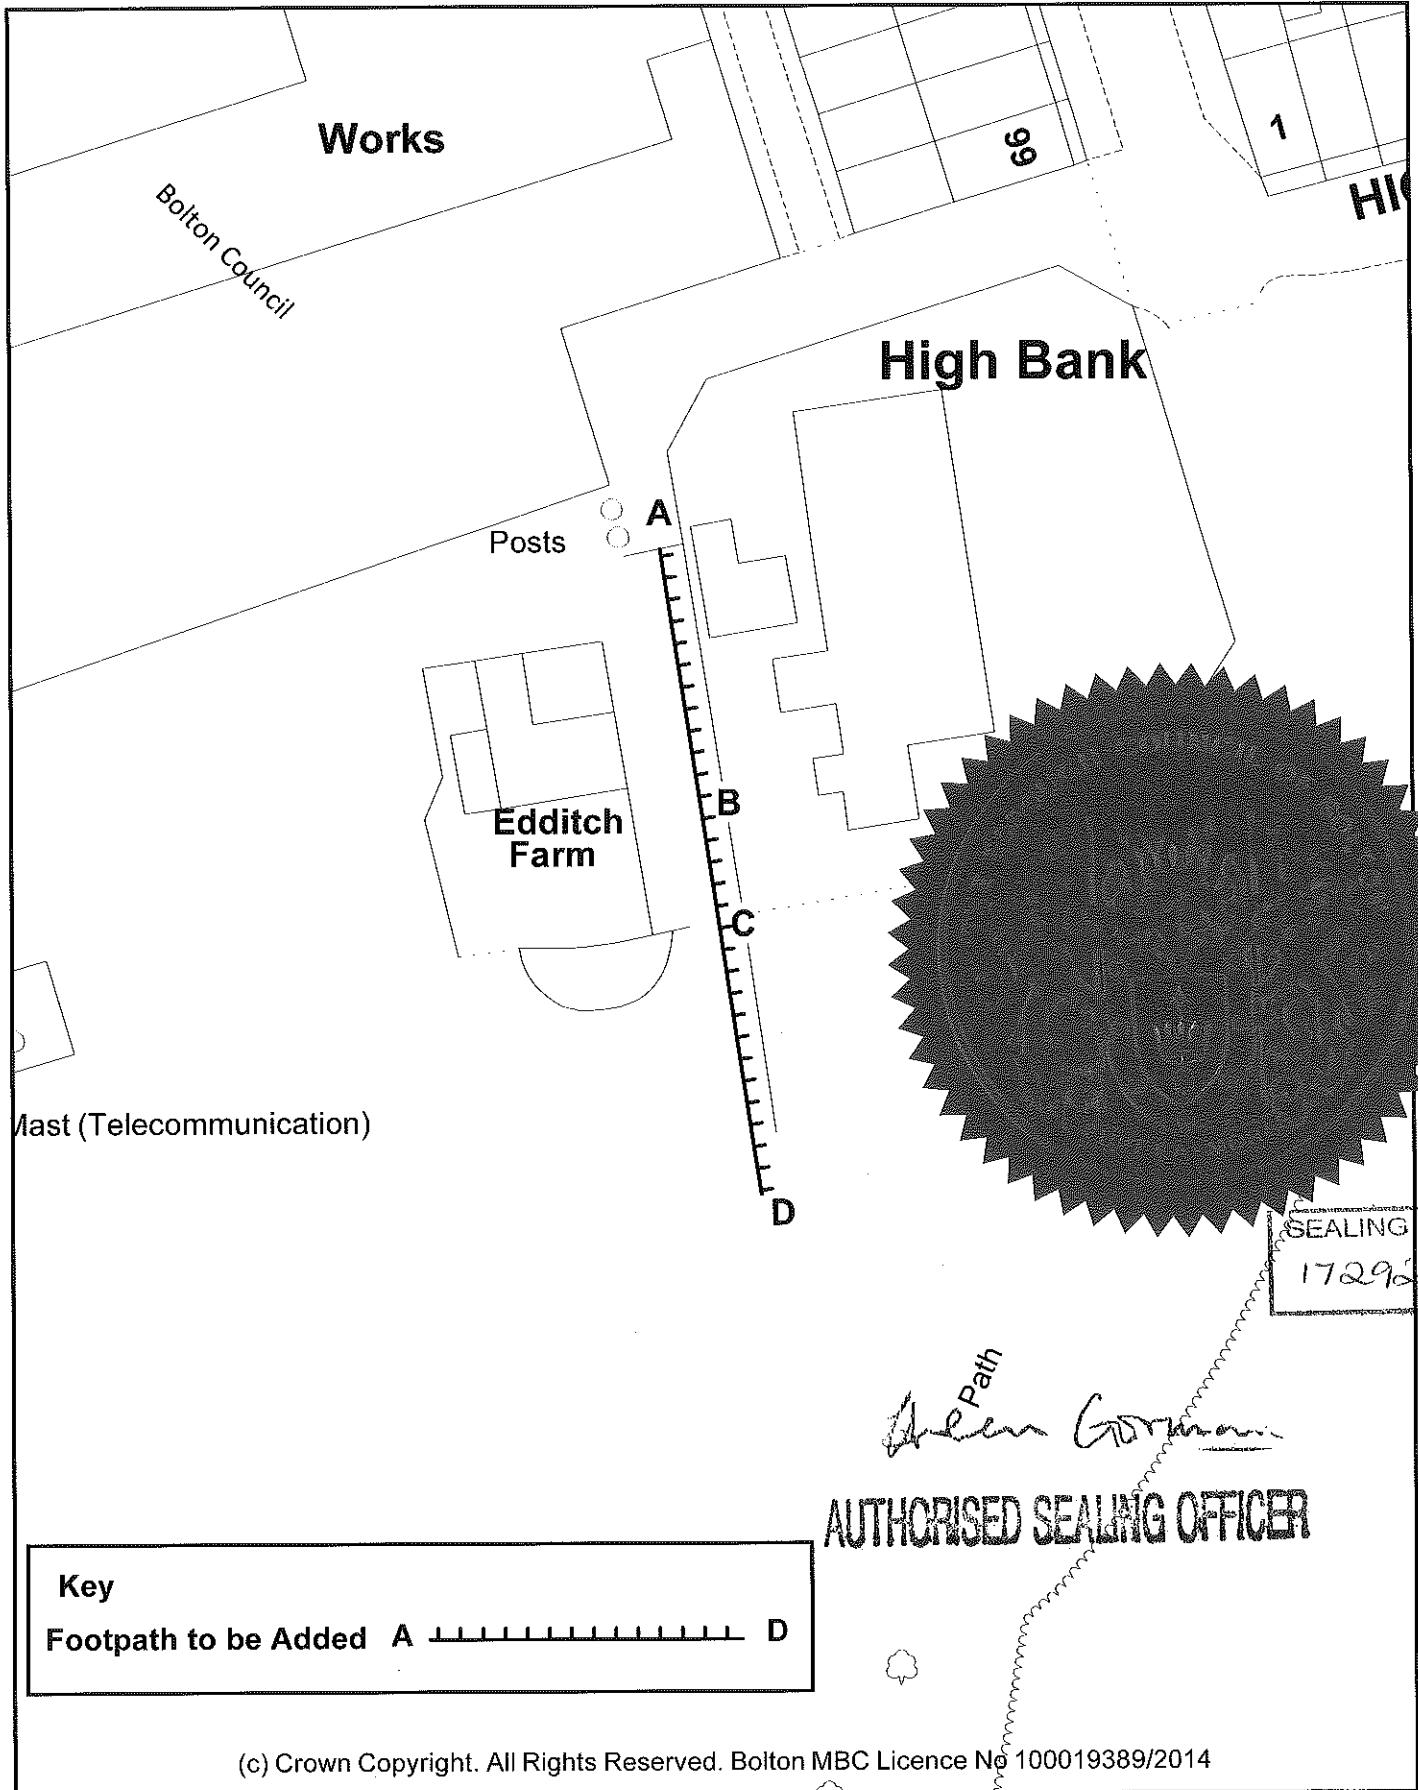

SEALING NO.
17292

Allen Gorman
Path

AUTHORISED SEALING OFFICER

Key
Footpath to be Added A  D

(c) Crown Copyright. All Rights Reserved. Bolton MBC Licence No 100019389/2014

Bolton Council HIGHWAY AND ENGINEERING PUBLIC RIGHTS OF WAY	ORDER MAP This Map forms part of the Bolton (Public Footpath No. 516 Bolton) Definitive Map Modification Order 2014			
	ENVIRONMENTAL SERVICES Malolm J. Cox. MBA. BSc. C Eng. MICE Director of Environmental Services The Wellsprings. Civic Centre. Bolton. BL1 1US	Date 05/11/2014	Scale 1 : 500	Drawn